


PREMISES

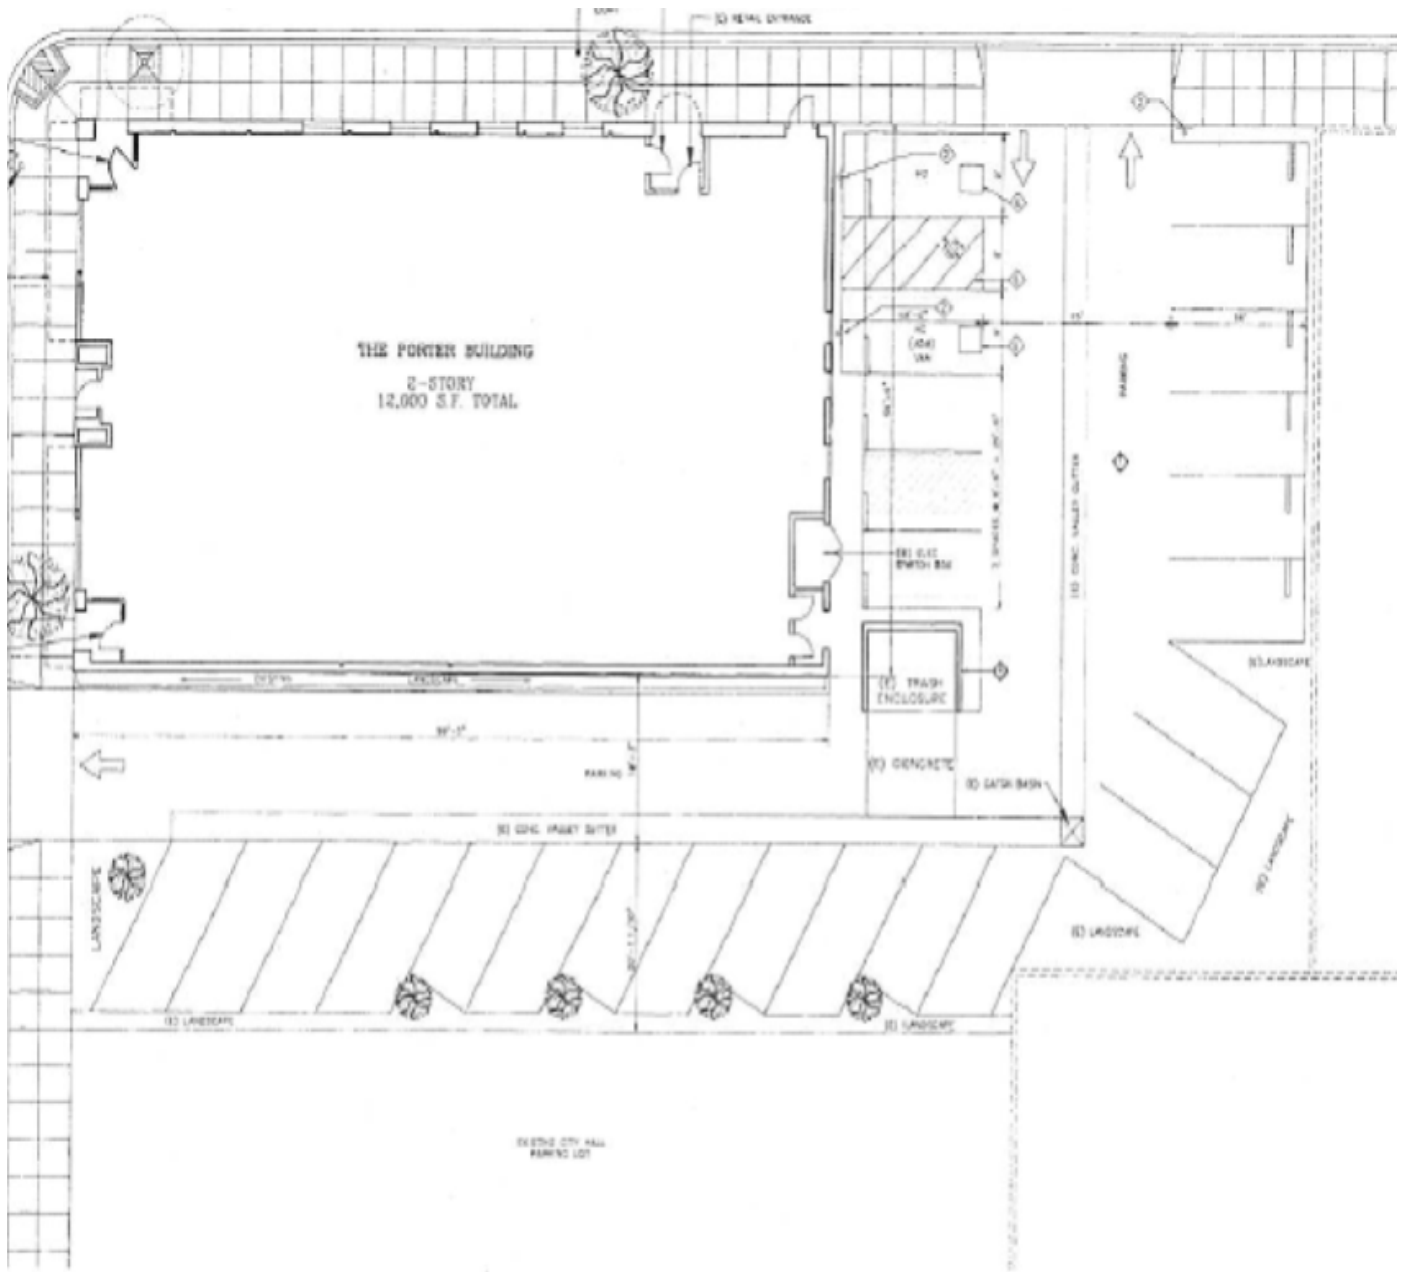

SITE PLAN (AS-BUILT)

SCALE 1/4" = 1'-0"

